



བསམ་གྲུབ་ཐྲུངས་མཁར་སྤྱོད་ཁང་།  
THROMDE ADMINISTRATION  
SAMDRUP JONGKHAR



SJT/ID/PIU-ADB/20/2022-2023/ 1073

Date: 05/12/2024

To,

Bkyston Post, S/Jongkhar

Thram No. -

Plot No. 84T-82

Location: Zone-B

Samdrup Jongkhar

Subject: Request for Payment of Sewer Household Connection Charges

We are pleased to inform that the sewerage household connection for your building/institution has been successfully completed as per our service requirement. In this regard, we kindly request you to remit the payment within 10 working days from the date of issuance of this letter into the following account number and furnish the screenshot of payment made:

101071727 (Thromde Welfare Scheme)

Failure to make payment within the stipulated timeframe may result in disconnection of the services. If you have any queries or clarification, please do not hesitate to contact the following officials during the office hours:


- |   |    |   |
|---|----|---|
| 1. Sonam Wangchuk   | OR | 2. Lok Man Tamang   |
| Project Manager   |    | PMSC Engineer   |
| Contact Number: +975-17454558   |    | Contact Number: +975-77205614   |
| Email: <a href="mailto:swangcuk@sjthromde.gov.bt">swangcuk@sjthromde.gov.bt</a> |    | Email: <a href="mailto:tamanglokman@gmail.com">tamanglokman@gmail.com</a> |

We thank you for your cooperation and commitment to maintaining a clean and hygienic community.

(Attested: The cost details and the as-built drawing for the sewer household connection is enclosed herewith)

Thanking you.

Yours Sincerely,


  
(Dorji Gyeltshen P)  
Executive Secretary

Copy to:

1. Dasho Thrompon, Samdrup Jongkhar Thromde for kind information.
2. Chief Engineer, ID, Thromde Administration for information.
3. Project Manager, PIU for information & necessary follow-up.
4. PMSC Engineer, for information & necessary follow-up.
5. CEO, Chimmi R.D Construction Pvt. Ltd for information.
6. Office Copy

PABX: +975 7 251616, +975 7 251619, +975 7 251629 Fax: +975 7 251305

# PLAN OF SEWERAGE HOUSE CONNECTION (SCALE : NTS)

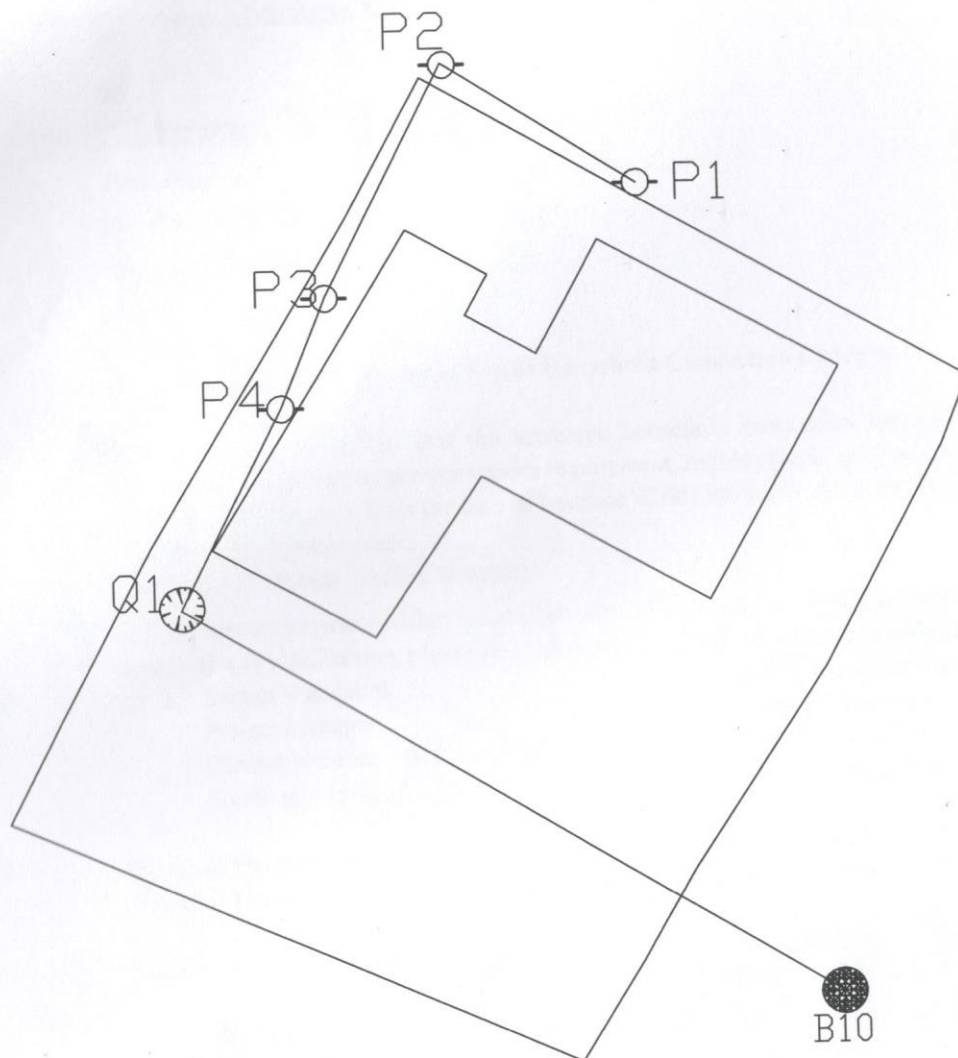

## PROPERTY DETAILS

\* Location = Zone-B  
 \* Plot No. = SGT-62 ✓  
 \* Thram No. =  
 \* Bldg. Type = Permanent  
 \* No. of Storey = G+1  
 \* No. of Flats/ Units =  
 \* Property Owner/s = Bhutan Post ✓  
 \* Contact No/ Address =  
 \* Email =

## HOUSE CONNECTION DETAIL

Chamber No	Coordinates		Distance in meter		
	Easting	Northing	From	To	
P1	243889.04	465464.36	P1	P2	9.53
P2	243880.96	465469.42	P2	P3	10.97
P3	243875.83	465459.72	P3	P4	4.99
P4	243873.94	465455.10	P4	Q1	9.36
Q1	243869.68	465446.77	Q1	B10	32.01
B10	243897.10	465430.26	B10		
					66.86

## COST DETAIL

Description of item	Qty	Units	Rate	Amount
7.1.1 Junction Box (JB)	0.00	each	10000.00	0.00
7.1.2 Inspection Chamber (P)	4.00	each	500.00	2000.00
7.1.3 Inspection Chamber (Q)	1.00	each	10000.00	10000.00
7.2.1 uPVC 110mm diameter (6PN)	0.00	meter	600.00	0.00
7.2.2 uPVC 160mm diameter (6PN)	66.86	meter	900.00	60174.00
7.3 Number of Connection	2.00 ✓	each	300.00	600.00
7.5 Reinstatement of paved surface	0.00	meter	700.00	0.00
7.6 Removal of old bypassed sewerage	0.00	HH	300.00	0.00
Extra item: Trenching and backfilling	0.00	meter	174.86	0.00
				72774.00

